 


BREMERTON-007996



~~Part A~~ power c

A strip of land 15 feet in width, 7.5 feet left and right of the following described centerline, situated in Section 14 Township 24 North, Range 1 East, Willamette Meridian, Kitsap County, Washington.

Commencing at the Northwest corner of said Section 14, thence South 88° 24' 00" East 2378.26 feet to a point on the State Inner Harbor Line; per State of Washington, Board of State Land Commissioners, Maps of Bremerton Tide Lands, 28 February 1911 (Page 5), said point being the True Point of Beginning; thence North 60° 59' 17" East 43.05 feet; thence South 74° 00' 43" East 76.00 feet; thence South 74° 14' 05" East 63.62 feet; thence South 60° 05' 54" East 96.00 feet; thence South 15° 05' 54" East 22.30 feet to a point on the State Inner Harbor Line and the Terminus Point of said easement.

~~strip~~ Parcel D

A strip of land 15 feet in width, 7.5 feet left and right of the following described centerline, situated in Section 14 Township 24 North, Range 1 East, Willamette Meridian, Kitsap County, Washington.

Commencing at the Northwest corner of said Section 14, thence South 85° 12' 49" East 2700.05 feet to a point on the State Inner Harbor line per State of Washington Board of State Land Commissioners, Maps of Bramerton Tide Lands, 28 February 1913. (Page 5); said point being the True Point of Beginning; thence North 39° 51' 44" East 31.88 feet; thence South 50° 08' 16" East 87.88 feet; thence along a curve having a central angle of 27° 46' 08" degree of curve to the left 216.04 feet; said curve being closed and which bears a radius of 208.16 feet; thence South 20° 08' 09" East 1.12 feet to a point on the State Inner Harbor line and the Terminus Point of said easement.


A strip of land 15 feet in width, 15 feet left of the following described centerline, situated in Section 14, Township 24 North Range 1 East, Willamette Meridian, Kitsap County, Washington.

Commencing at the Northwest corner of said Section 14, thence South 84° 22' 43" East 2996.59 feet to a point on the State Inner Harbor line of State of Washington Board of State Land Commissioners, Maps of Bremerton Tide Lands, 28 February 1913 (Page 5); said point being the True Point of Beginning; thence North 70° 19' 08" East along said Inner Harbor line 275.00 feet to the Terminus Point of said easement.

A strip of land 15 feet in width, 7.5 feet left and right of the following described centerline, situated in Section 14, Township 24 North, Range 1 East, Willamette Meridian, Kitsap County, Washington.

Commencing at the Northwest corner of said Section 4; thence South 87° 02' 33" East 3327.31 feet to a point on the State Inner Harbor line per State of Washington Board of State Land Commissioners, Maps of Bemerton Tide Lands, 28 February 1913; (Page 5); said point being the True Point of Beginning; thence North 47° 21' 44" East 10.45 feet; thence North 69° 51' 45" East 15.40 feet; thence South 16° 16' 16" East 15.40 feet; thence South 2° 21' 21" West 13.07 feet to a point on the State Inner Harbor line and the Terminus Point of said easement.

Except that portion not lying within aquatic state-owned land

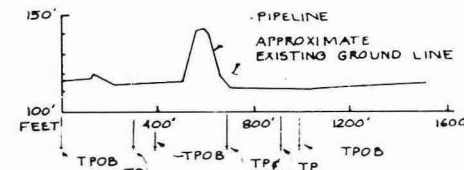

PROFILE
SCALE: 1"=400'

RECORDER'S CERTIFICATE

Filed for record this _____ day of _____, 19__ at _____ N. in Book _____ of Surveys at page _____ at the request of _____

Manager	Superintendent of Records
---------	---------------------------

SURVEYOR'S CERTIFICATE

This map correctly represents a survey made by me
or under my direction in conformance with the
requirements of the Survey Recording Act at the
request of CITY OF BREMERTON
in AUGUST, 1983.

RECORD SURVEY
for
CITY OF BREMERTON
DNR EASEMENT
PORT WASHINGTON